


10cm

10cm

20cm

SCALE WITH CAUTION (use top & side scale bars to check for distortion or reduction)

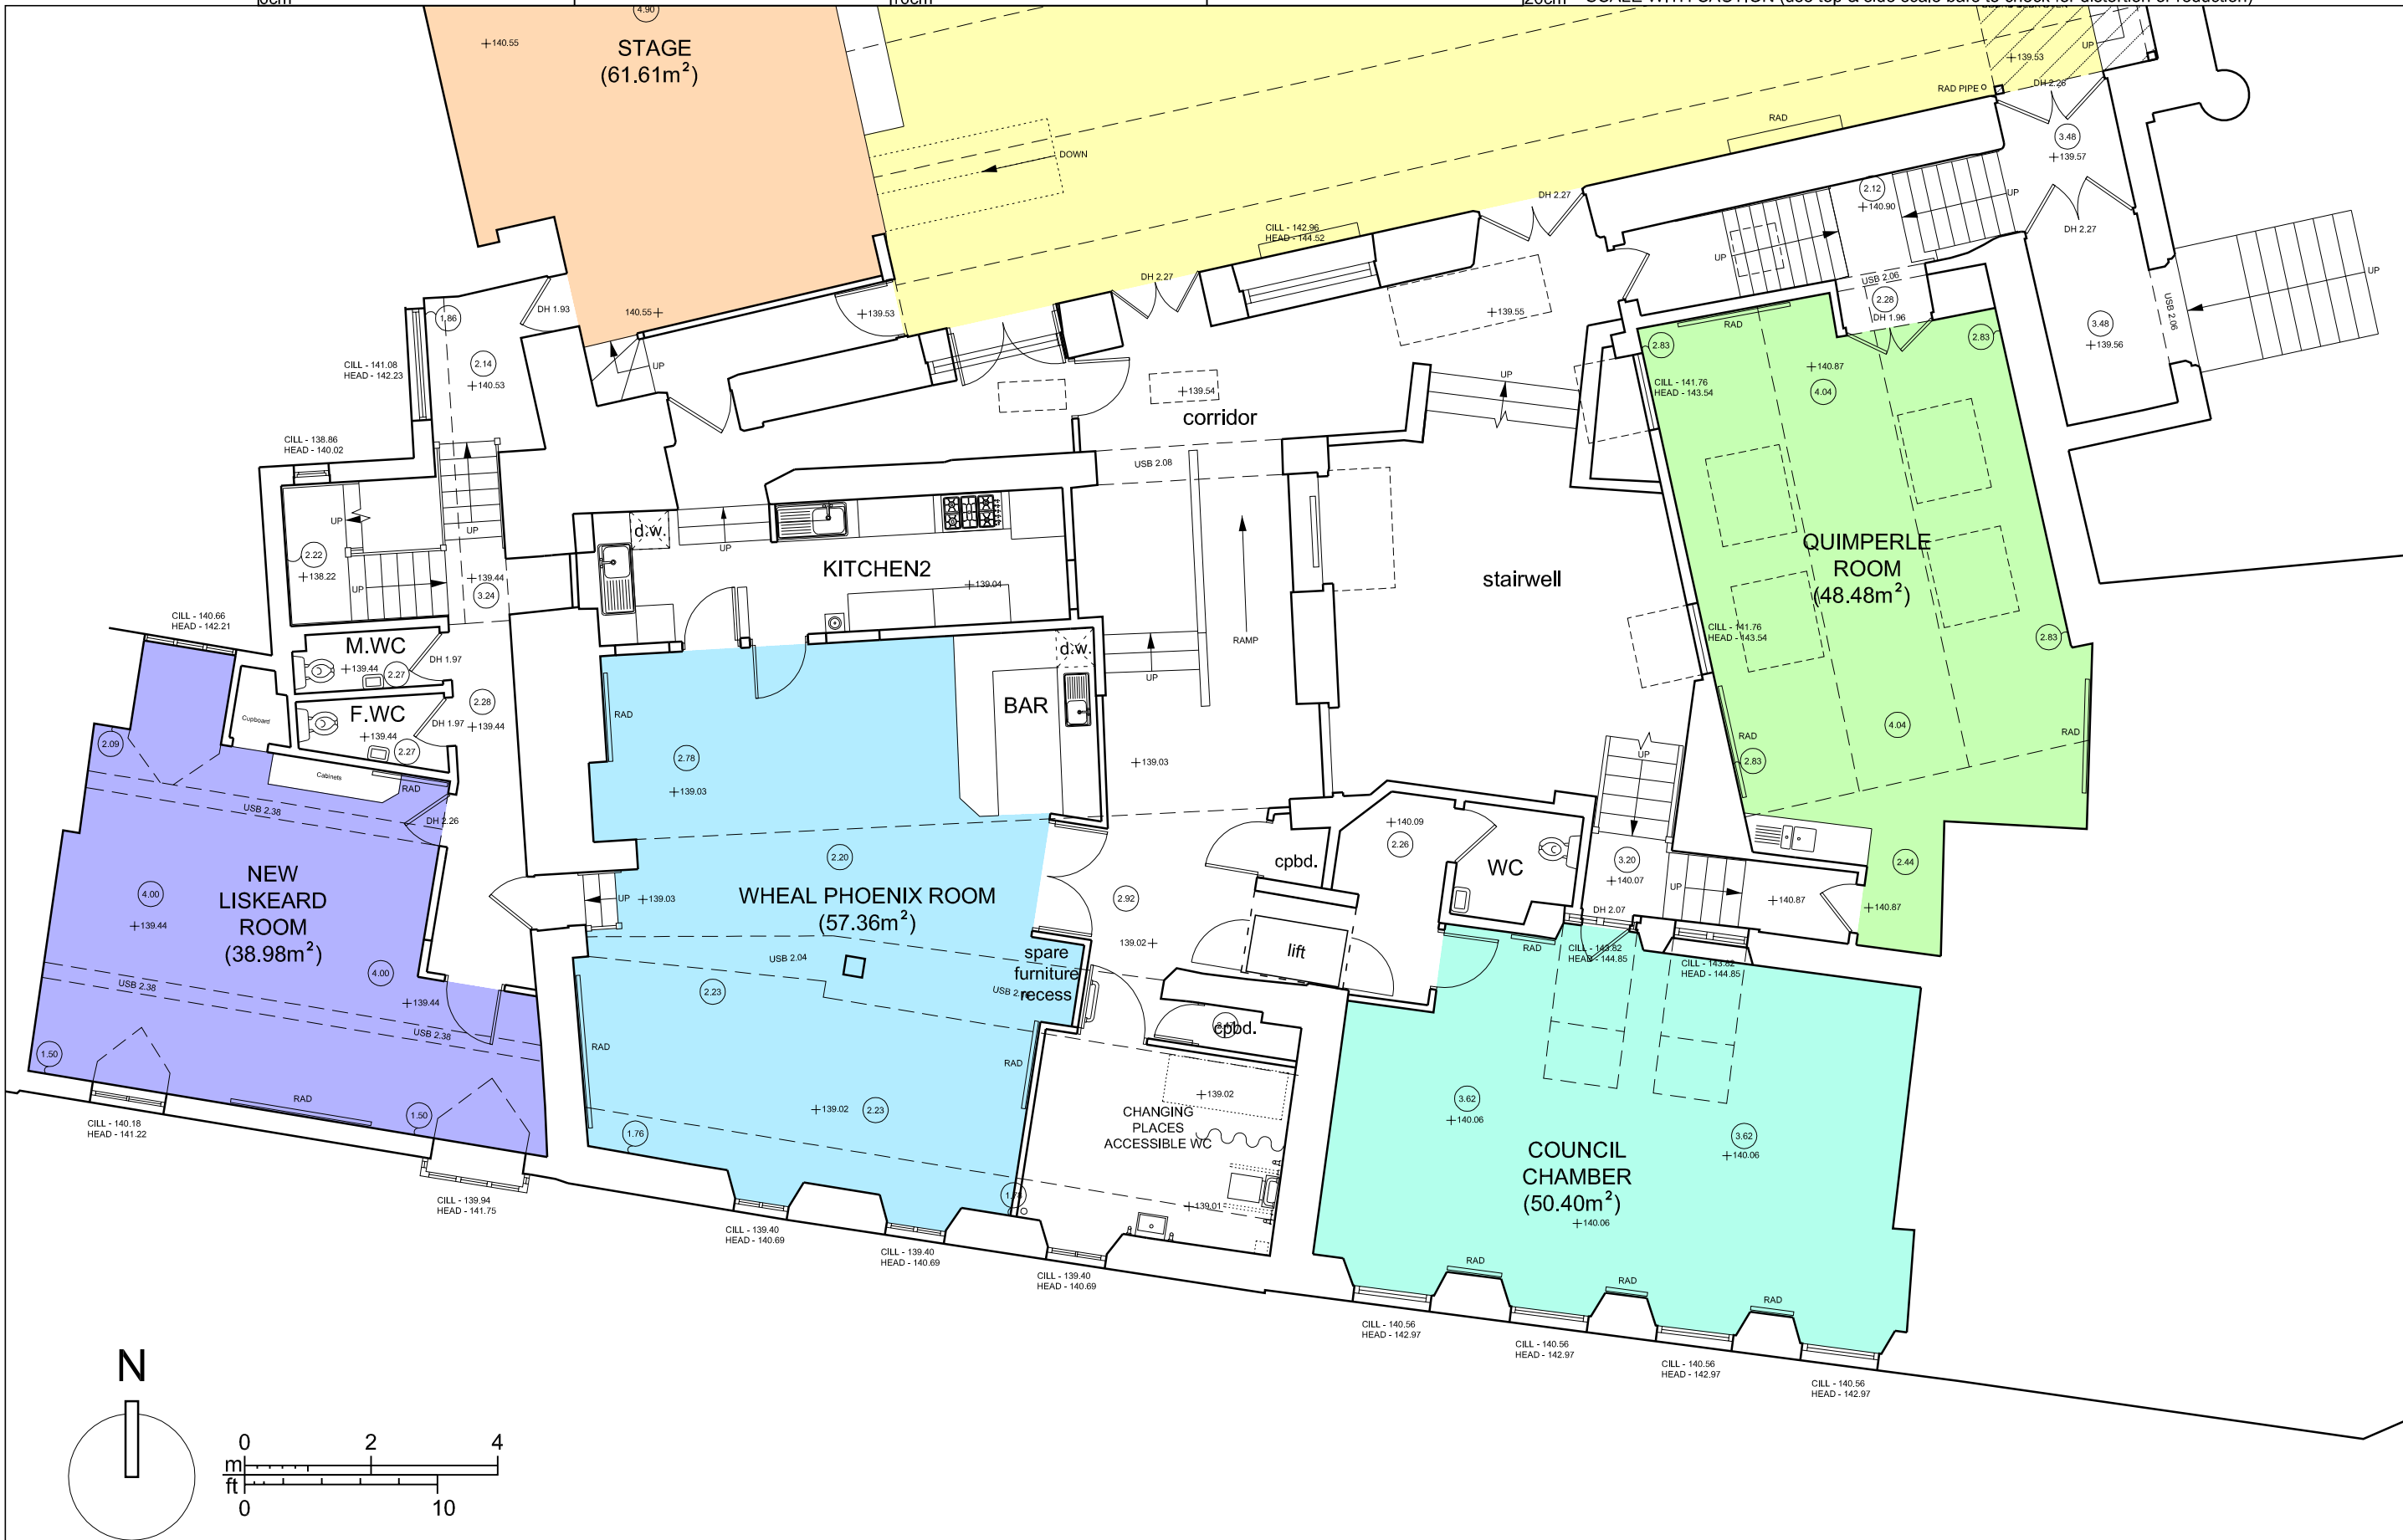

STUDIO WINTER

Chartered Architect

The Guildhall Liskeard Cornwall PL14 3JE T: 01579 345354 F: 01579 347527 E: mail@studowinter.com
 This drawing is Copyright to Studio Winter Chartered Architect © all rights reserved. In all cases use figured dimensions, work only from checked site dimensions.
 Report any discrepancies immediately.

Studio Winter Chartered Architect is a trading name of C M Architect Limited

THE PUBLIC HALL, LISKEARD I:100 [A3] MARCH 2021 AS BUILT DRAWINGS: FIRST FLOOR PLAN SOUTH 15/1395/103 A

A	01/04/2021	CGM	areas added
Let.	Date dd/mm/yy	Drawn	Revision Description

(This drawing was drafted from survey drawings by others with any errors or omissions therein)