0cm 10cm 20cm SCALE WITH CAUTION (use top & side scale bars to check for distortion or reduction)

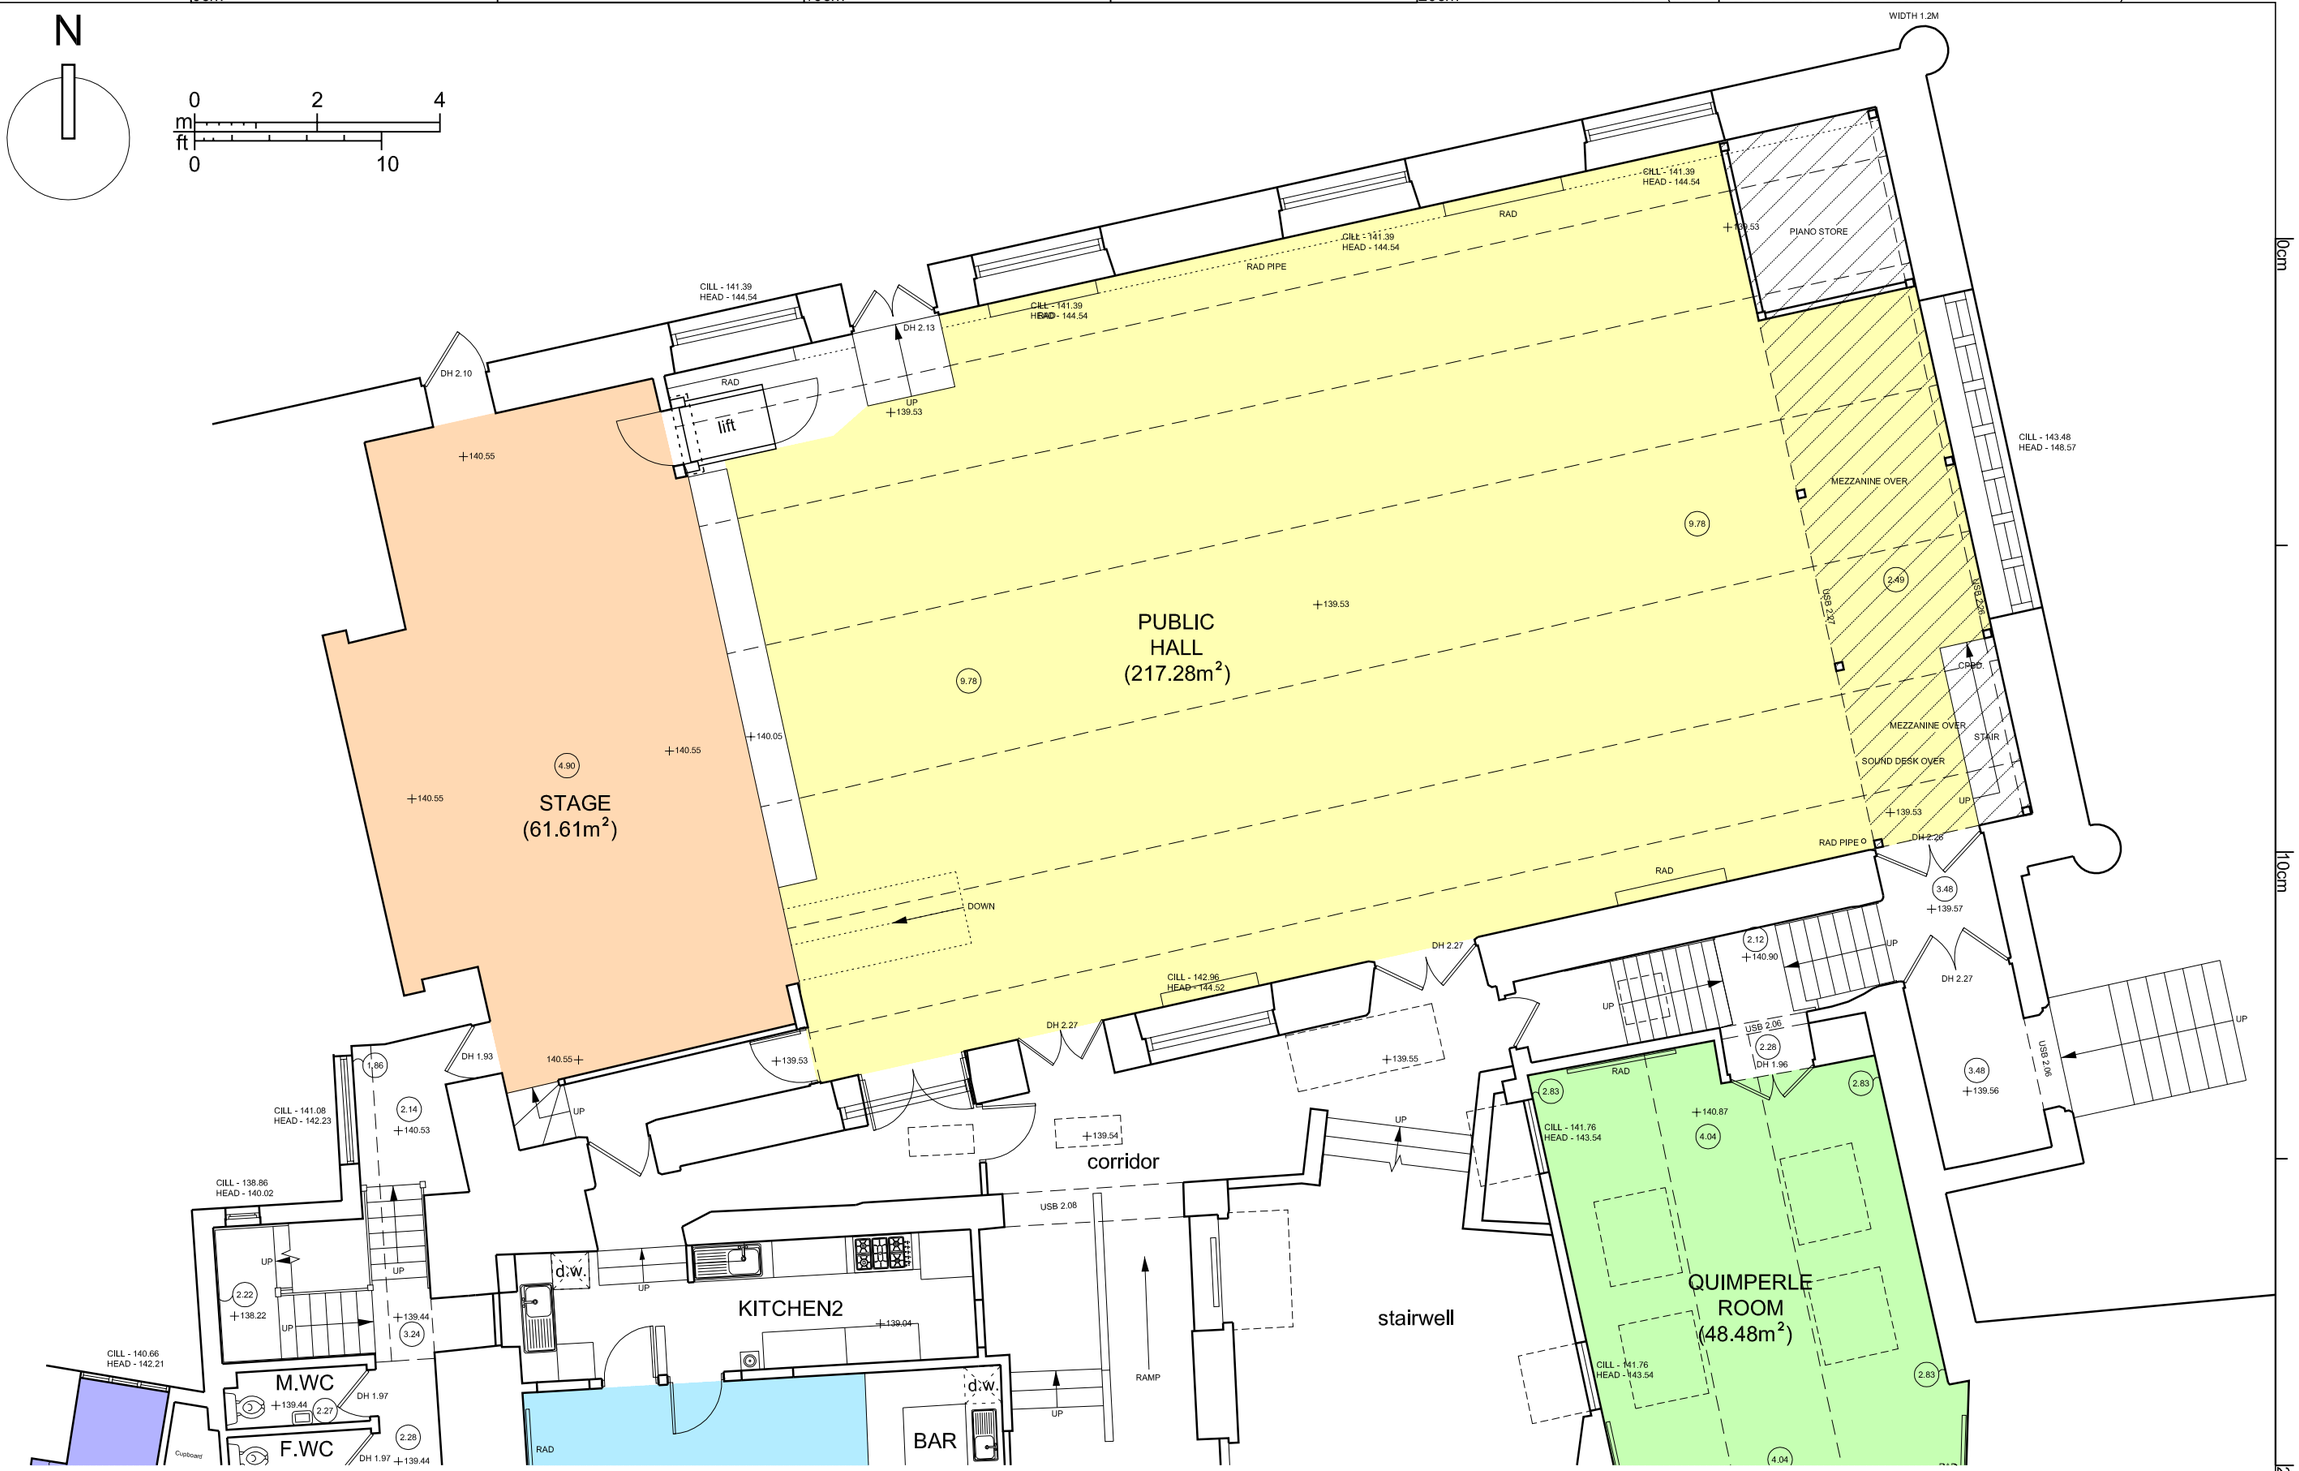

STUDIO WINTER

Chartered Architect

The Guildhall Liskeard Cornwall PL14 3JE T: 01579 345354 F: 01579 347527 E: mail@studiowinter.com

This drawing is Copyright to Studio Winter Chartered Architect © all rights reserved. In all cases use figured dimensions, work only from checked site dimensions. Report any discrepancies immediately.
Studio Winter Chartered Architect is a trading name of C M Architect Limited

THE TO THE PUBLIC HALL, LISKEARD 1:100 [A3] MARCH 2021 AS BUILT DRAWINGS: FIRST FLOOR PLAN NORTH 15/1395/104 A

Let.	Date dd/mm/yy	Drawn	Revision Description
A	01/04/2021	CGM	areas added

(This drawing was drafted from existing hand drawings by others with any errors or omissions therein)